

## AS CONSTRUCTED DRAWING

## PIC CONSENT No.

Assessment No.\_\_\_\_\_

Licensed Plumber\_\_\_\_\_ License No.\_\_\_\_\_

Property Address\_

Compliance No.\_\_\_\_\_

**IMPORTANT –** This drawing is to become the only permanent record; please ensure accuracy\*.

BASIC CHECKLIST


OFFSETS
DEPTH OF SEWER
NORTH ARROW
DIMENSION TO FITTINGS
2 TITLE BOUNDARIES
INSPECTION OPENING
LENGTH OF RUN



2 Boys Home Rd Newhaven, Vic 3925 P | 1300 720 711 F | 03 5956 4101 westport@westernportwater.com.au ABN | 63 759 106 755

## **Guidelines for As Constructed Drawings**

It is import to realise that the "As Constructed drawing" will probably be the only permanent record of the sewer location within the property boundary. \* Your drawing may be rejected by Westernport Water (WW) if it does not define the location of the sewer, offsets and measurements, all bends and significant fittings.

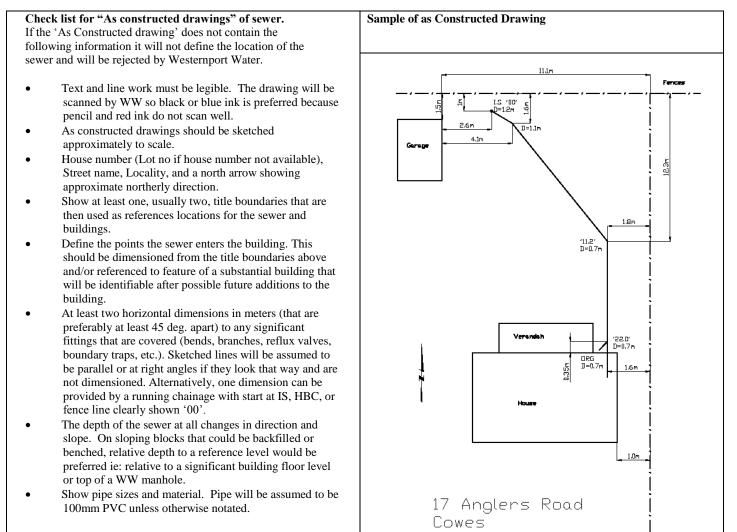

Abbreviations and Symbols					ures	Total No.
AGD	Above Ground Drain	HBC	House Branch Connection	1	Toilet (WC)	
AP	Altering Pipe	IO	Inspection Opening	2	Bath	
90	Bend 100mm x 90°	IS	Inspection Shaft	3	Shower	
BT	Boundary Trap	JU	Jump Up	4	Basin	
HC	Heavy Cover	ORG	Overflow Relief Gully	5	Sink	
CI	Cast Iron Pipe	RV	Reflux Valve	6	Trough	
DG	Disconnector Gully	VC	Vitrified Clay Pipe	7	Dishwasher	
DV	Drainage Vent		(Rubber Ring Jointed)	8	Washing Machine	
FW	Floor Waste Gully	90	Bend 100mm x 90°	9	Bidet	
GV	Ground Vent	45	Bend 100mm x 45°	10	Swimming Pool	
					Other	